






A BUILDING ELEVATION

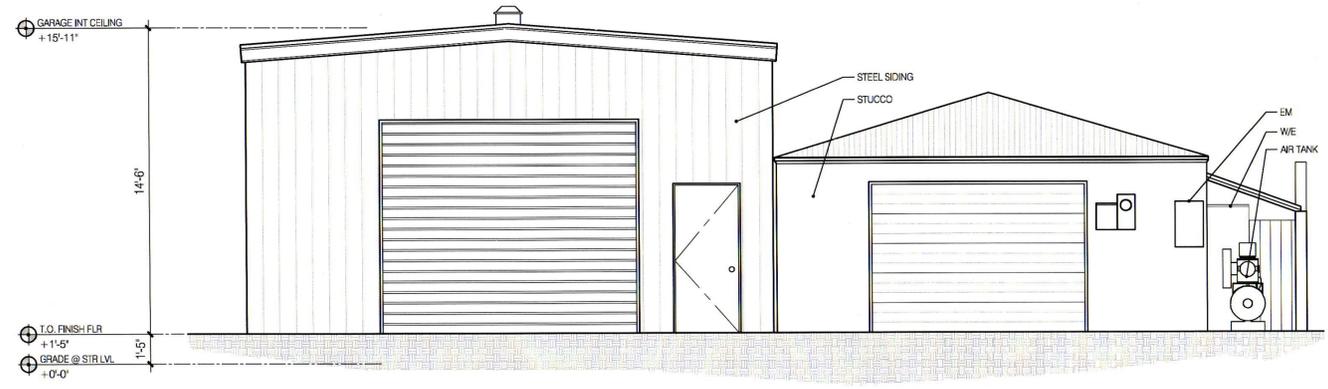

C BUILDING ELEVATION

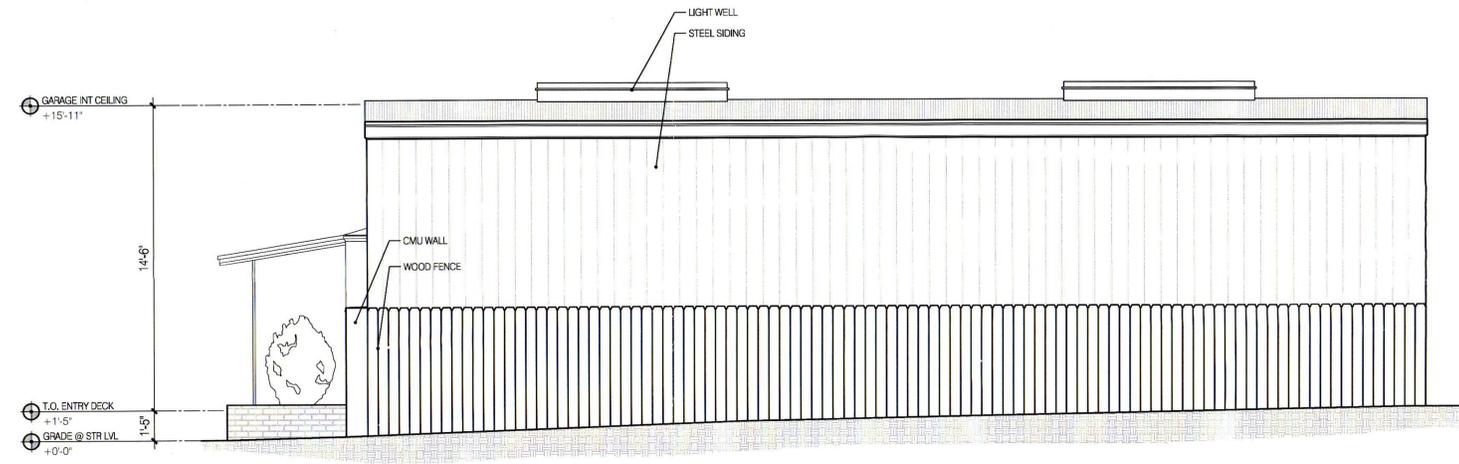

B BUILDING ELEVATION

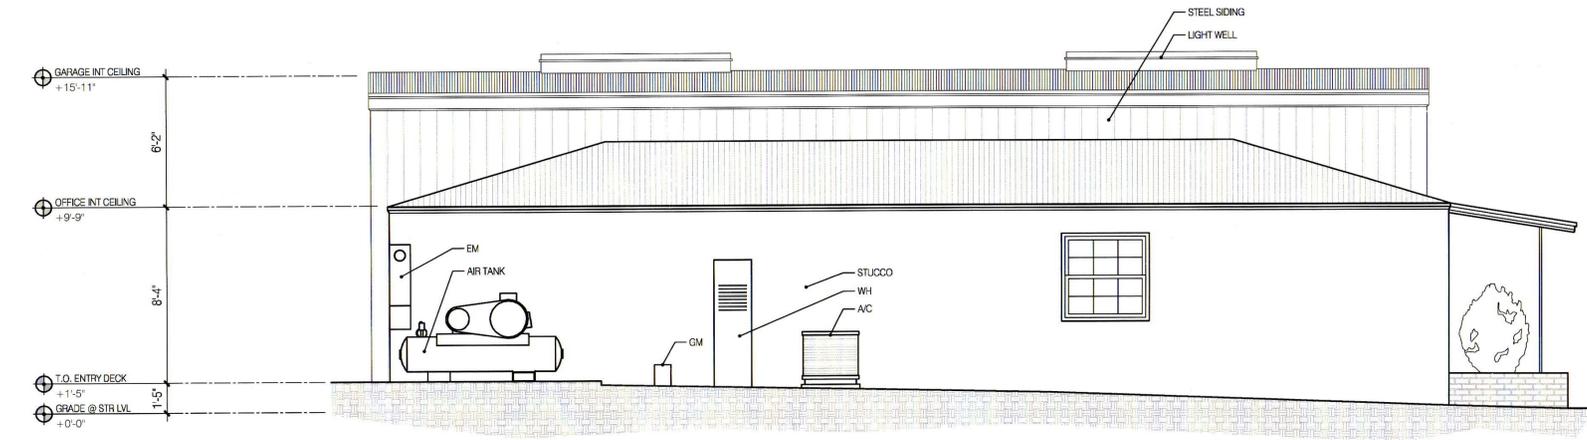

D BUILDING ELEVATION

ryder design & architecture
 eric@ryderdesign.com www.ryderdesign.com



TI @
 5557 S CENTINELA AVE
 LOS ANGELES, CA 90066

EXTERIOR ELEVATION
 REMARKS:
 AS BUILT
 CUP SUBMITTAL
 DATE:
 20131029
 20131121

All designs, ideas, arrangements and plans indicated by these drawings are the property and copyright of the Architect and shall not be used on any other nor be disclosed to any other person for any use whatsoever without written permission. RYDER design and/or its principals and employees waives any and all liability or responsibility for problems that may occur when these plans, drawings, specifications, and/or designs are followed without the professional guidance of RYDER design.

DRAWN BY:	JT
JOB NO.:	1318A
SCALE:	1/4" = 1'

SHEET
A300

RYDER design: 1318A, 5557 S CENTINELA AVE 24" X 36"