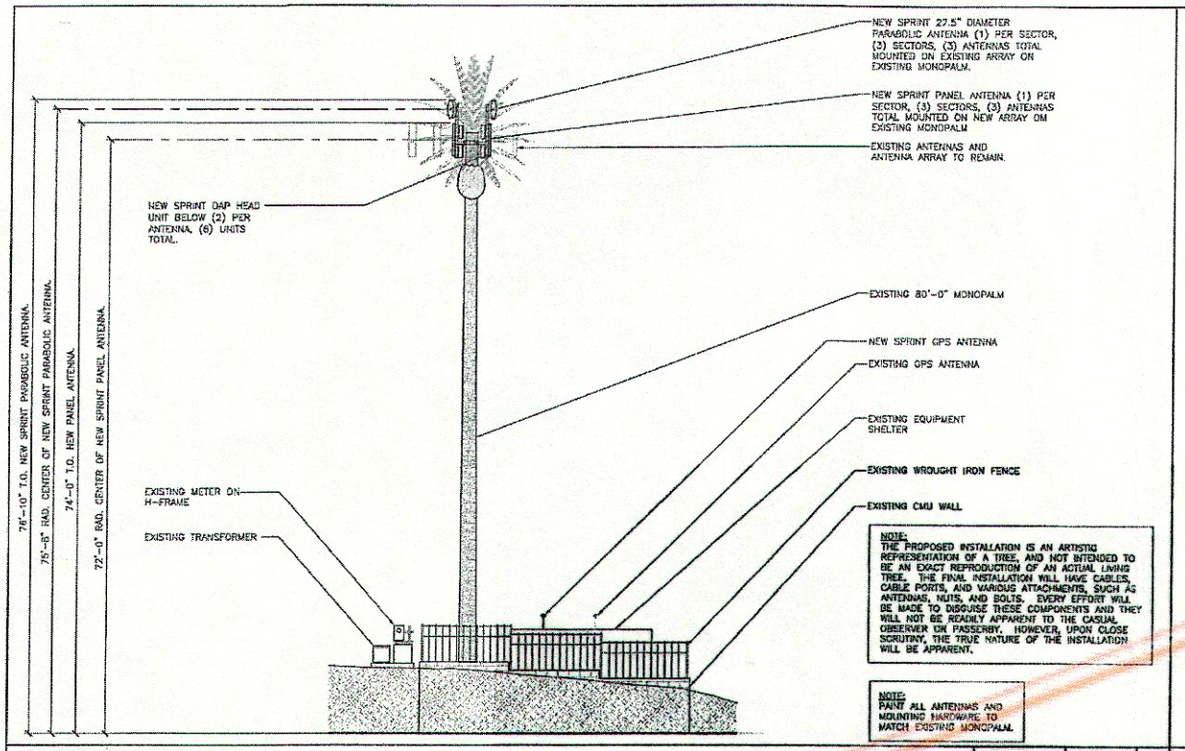

NORTH ELEVATION — SCALE: 1/8"=1'-0" — 3

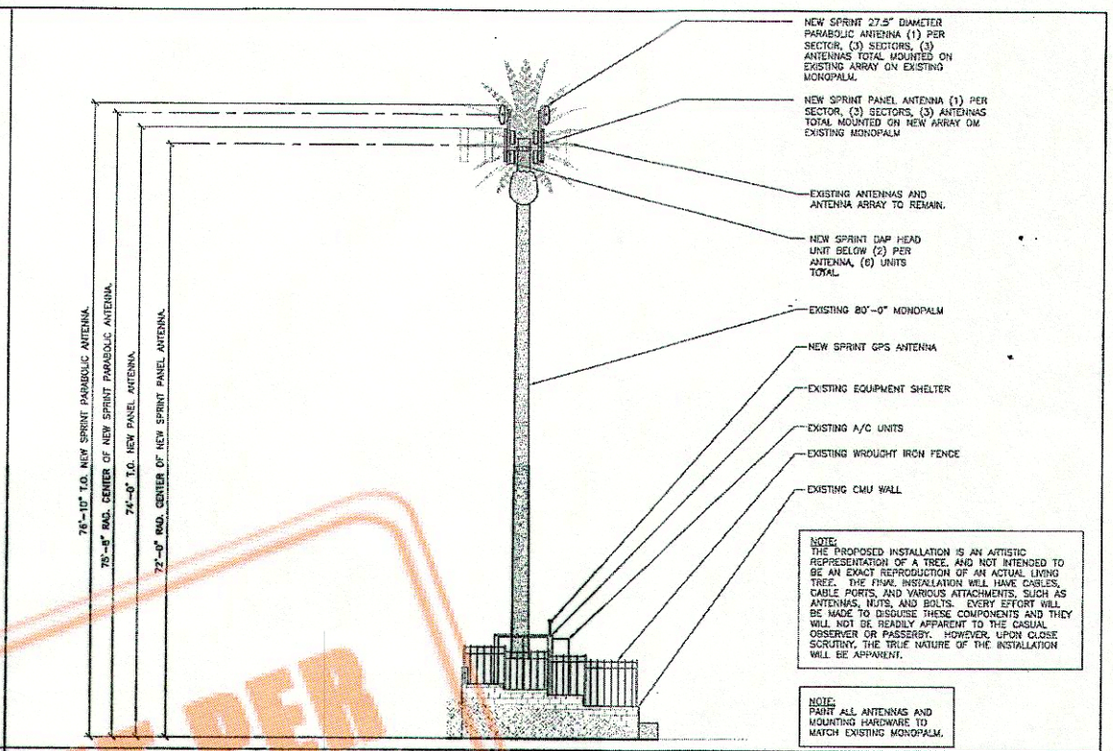

WEST ELEVATION — SCALE: 1/8"=1'-0" — 1

NOT USED — 4

NOT USED — 2

BUILT PER DESIGN

HP COMMUNICATIONS INCORPORATED

SEP 03 2010

NATIONAL ENGINEERING & CONSULTING, INC.
22382 GILBERTO, SUITE 200
RANCHO SANTA MARGARITA, CA 92688-2153
PHONE: (949) 766-7774
FAX: (949) 766-7769

Sprint
4400 CARILLON POINT
KIRKLAND, WA 98033

CA-LOS4804-A
GAREY LA56XC210F
233 BASELINE RD.
POMONA, CA 91750

REVISIONS			
2	04/07/10	90% ZONING DRAWINGS REVISIONS	FR
3	04/12/10	DRM REVISIONS	FR
4	04/22/10	100% ZONING	JH
5	05/04/10	100% ZONING - PLAN CHECK	JH
6	06/10/10	100% ZONING - REV	JH
7	07/12/10	90% CONSTRUCTION	FR
8	07/22/10	100% CONSTRUCTION	FR

REGISTERED PROFESSIONAL ENGINEER MICHAEL S. OSTER C 034468 EXP. 12-31-2010 STRUCTURAL STATE OF CALIFORNIA

ELEVATIONS

JOB NUMBER:	SHEET NUMBER:
CA-LOS4804-A	A-2