NOTES:
1. NO ODOR, NOISE, VIBRATIONS SHALL BE EMITTED SO THAT IT EXCEEDS THE GENERAL LEVEL OF ODOR, NOISE OR VIBRATION EMITTED BY USES OUTSIDE OF THE SITE.
2. NO TREES ARE PROPOSED TO BE REMOVED. RESTORE VEGETATION DISTURBED IN TRENCHING. NO PROTECTED PLANTS ARE FOUND ON THE PROPERTY.
3. NO IMPORT OR EXPORT OF SOIL PROPOSED.
4. PARKING PROPOSED TO USE ONSITE, NON-DESIGNATED SPACES.
5. NO GRADING IS PROPOSED.
6. NO HILLY TERRAIN OR DRAINAGE PROBLEMS EXIST.
7. SITE PLAN REVIEW WITHOUT A VARIANCE.
8. ALL EXISTING STRUCTURES TO REMAIN.
9. THIS SITE PLAN HAS BEEN CREATED WITHOUT THE BENEFIT OF A SITE SURVEY AND SHOULD BE USED FOR CONCEPTUAL PURPOSES ONLY.

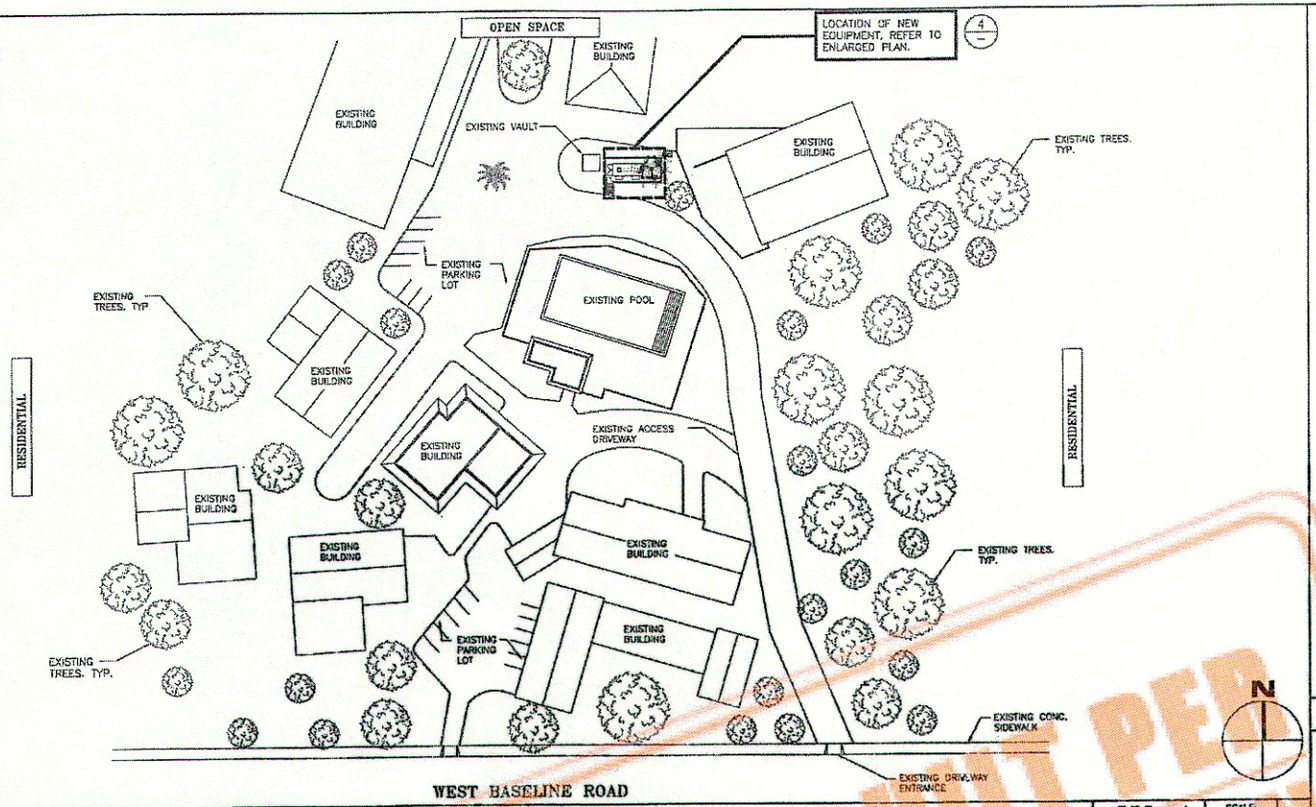


## SITE PLAN

SCALE: 1"=50'-0" 3

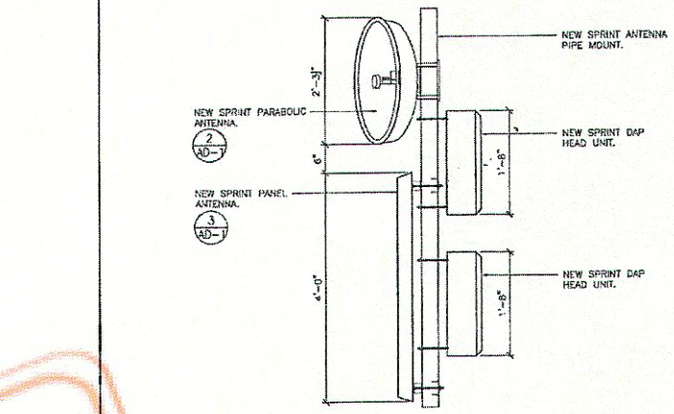


## ANTENNA ELEVATION

SCALE: N.T.S 1

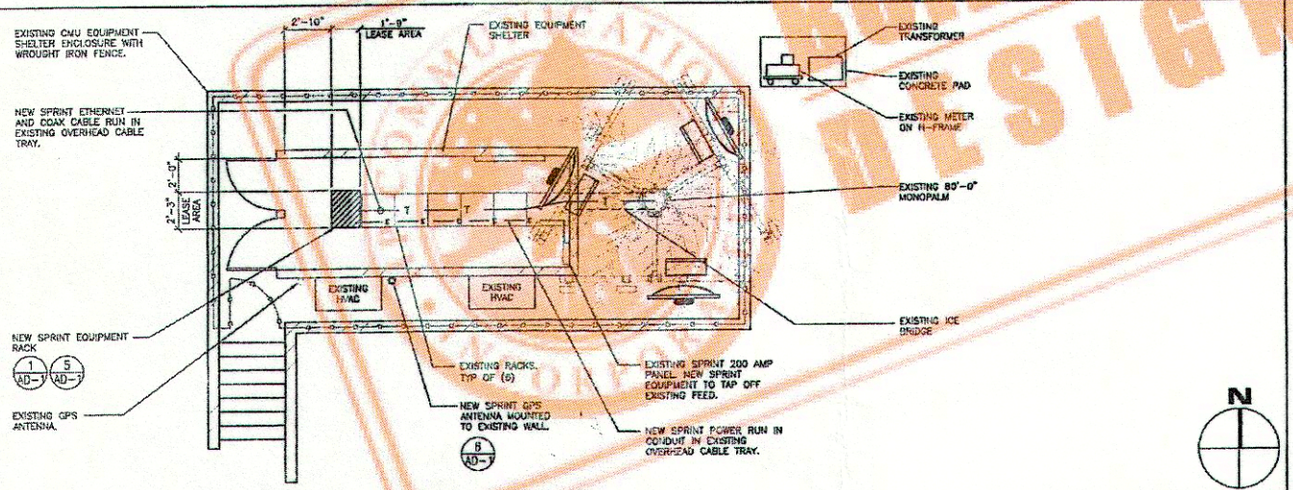


## EQUIPMENT LAYOUT PLAN

SCALE: 1/4"=1'-0" 4

BUILT PER DESIGN

SEP 03 2010

| RF CONFIGURATION | | | |
|---|---|---|---|
| SECTOR | # OF PARABOLIC ANTENNAS | AZIMUTH PARABOLIC ANTENNAS | # OF PANEL ANTENNAS |
| A | 1 | – | 1 |
| B | 1 | – | 1 |
| C | 1 | – | 1 |

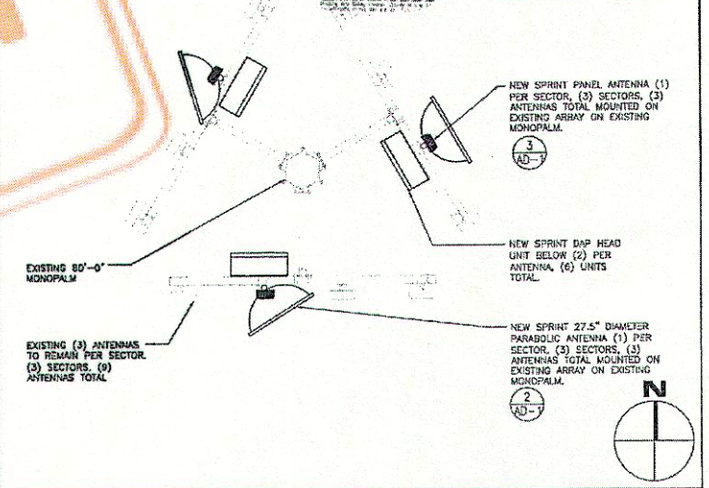


## ANTENNA LAYOUT PLAN

SCALE: N.T.S 2


NATIONAL ENGINEERING & CONSULTING, INC.
22362 GILBERTO, SUITE 200
RANCHO SANTA MARGARITA, CA 92688-2153
PHONE: (949) 766-7774
FAX: (949) 766-7789


Sprint
4400 CARILLON POINT
KIRKLAND, WA 98033

**CA-LOS4804-A**
**GAREY LA56XC210F**
233 BASELINE RD.
POMONA, CA 91750

REVISIONS

| | | | |
|---|---|---|---|
| 2 | 04/07/10 | 90% ZONING DRAWINGS REVISIONS | FR |
| 3 | 04/12/10 | DRM REVISIONS | FR |
| 4 | 04/22/10 | 100% ZONING | JH |
| 5 | 06/04/10 | 100% ZONING - PLAN CHECK | JH |
| 6 | 06/10/10 | 100% ZONING - REV | JH |
| 7 | 07/12/10 | 90% CONSTRUCTION | FR |
| 8 | 07/22/10 | 100% CONSTRUCTION | FR |

REGISTERED PROFESSIONAL ENGINEER
JAMES HOWARD
C 034468
EXP 12-31-2010
ELECTRICAL
STATE OF CALIFORNIA

# SITE PLAN, EQUIPMENT LAYOUT PLAN, ANTENNA LAYOUT PLAN AND ANTENNA ELEVATION

| JOB NUMBER: | SHEET NUMBER: |
|---|---|
| CA-LOS4804-A | A-1 |