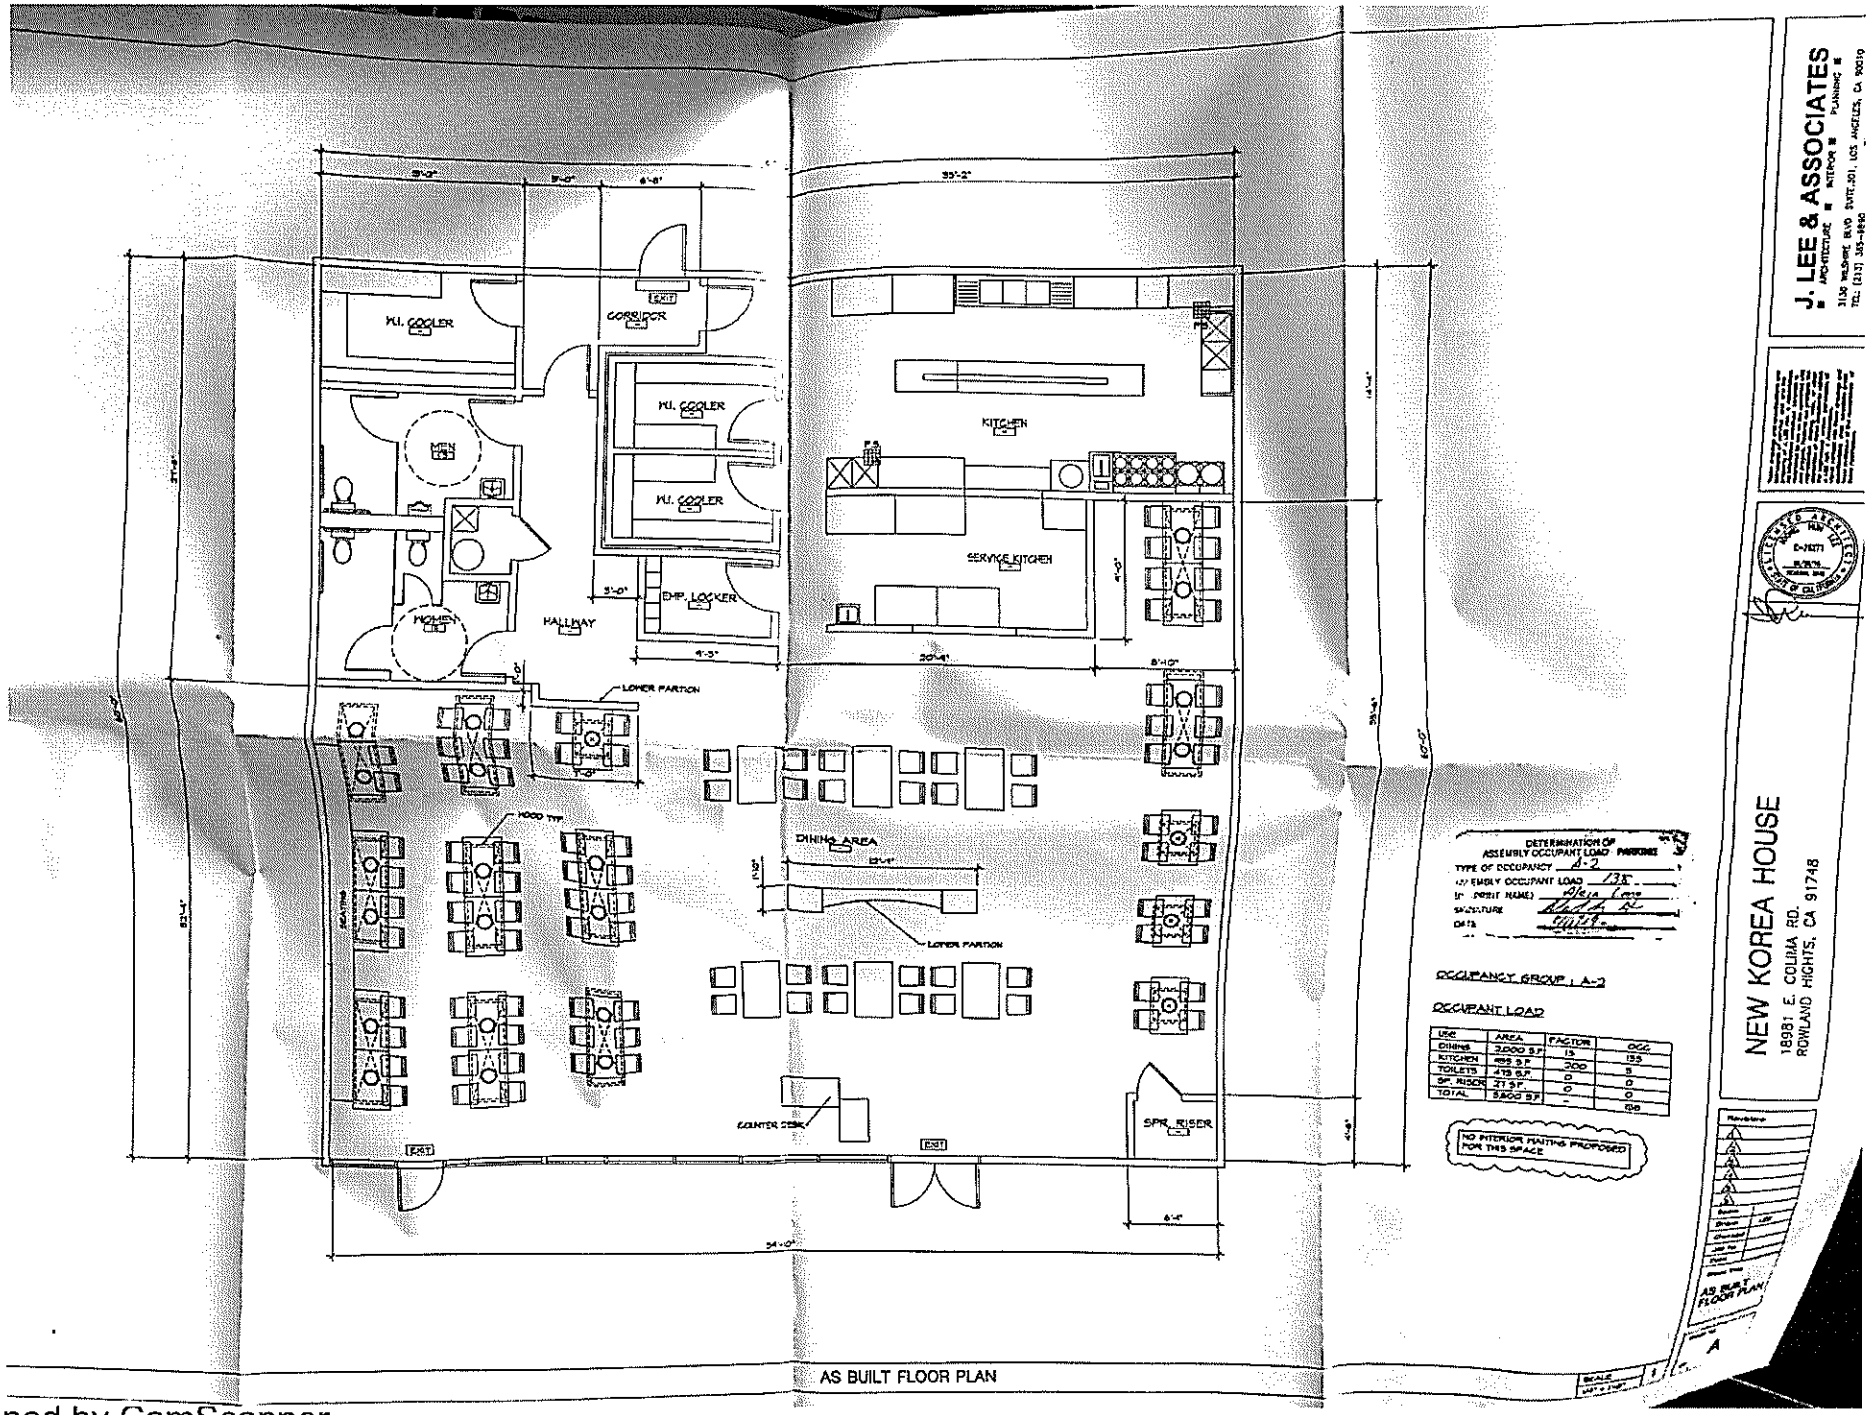

AS BUILT FLOOR PLAN

Scanned by CamScanner