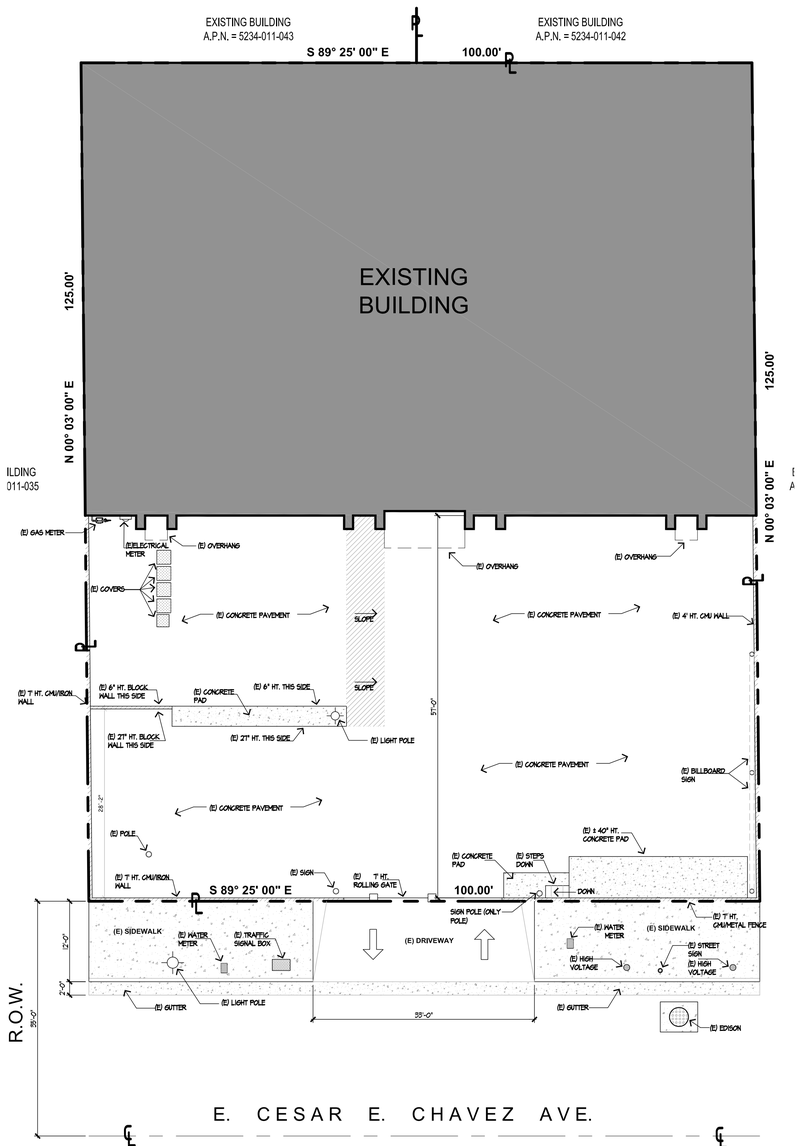

EXISTING SITE PLAN

SCALE 3/32"=1'-0"

N O R T H

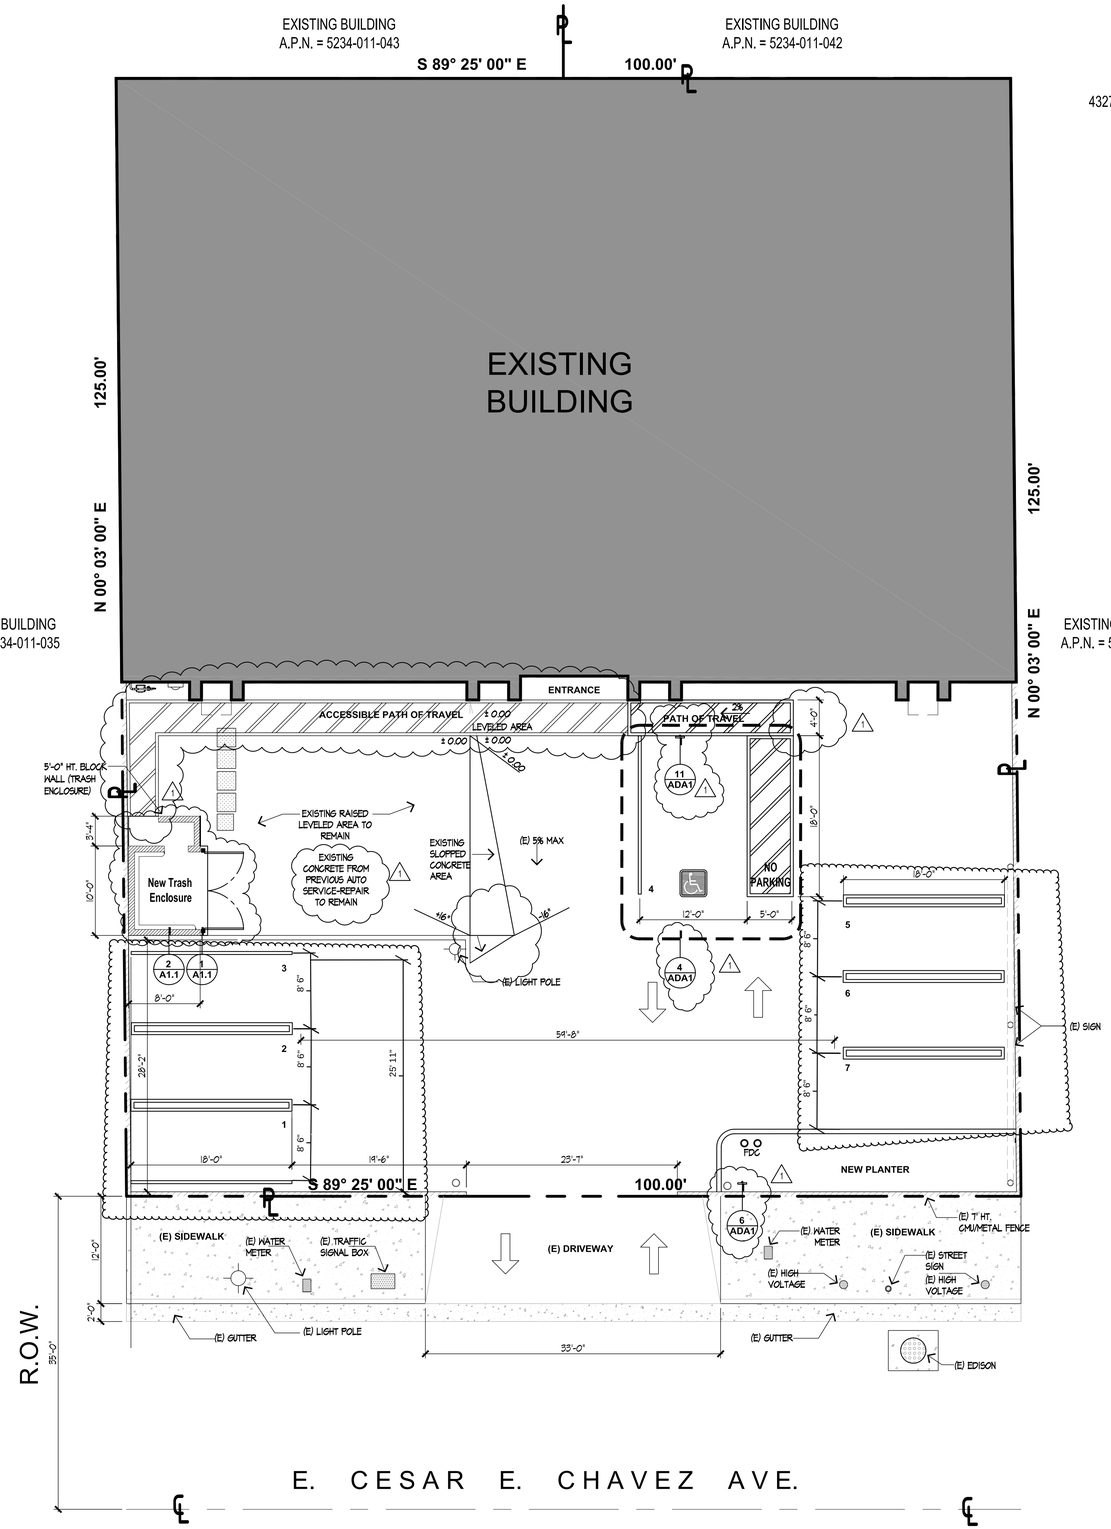

SITE PLAN

SCALE 1/8"=1'-0"

N O R T H

FOOTHILL

• PROJECT MANAGEMENT •

www.foothillmgt.com

CORRIE D. KATES

1590 Adams Avenue, #4403
Costa Mesa, CA 92628-4403
(760) 200-1685-Phone/Fax
design@foothillmgt.com

CA 1901
4327 EAST CESAR E. CHAVEZ
LOS ANGELES, CA.
A.P.N. = 5234-011-036

ARCHITECT OF RECORD

LICENSED ARCHITECT
KEVIN A LEONARD
C19980
EXP. 3-31-17
STATE OF CALIFORNIA

THE USE OF THESE PLANS AND SPECIFICATIONS SHALL BE RESTRICTED BY THE ORIGINAL SITE FOR WHICH THEY WERE PREPARED AND PUBLICATION THEREOF IS EXPRESSLY LIMITED TO SUCH USE. REUSE, REPRODUCTION OR PRODUCTION BY ANY METHOD IN WHOLE OR IN PARTIS PROHIBITED. TITLE TO THE PLANS AND SPECIFICATONS REMAINS WITH FOOTHILL PROJECT MANAGEMENT WITHOUT PREJUDICE VISUAL CONTACT WITH THESE PLANS AND SPECIFICATIONS SHALL CONSTITUTE PRIMA FACIAL EVIDENCE OF THE ACCEPTANCE OF THE RESTRICTIONS

REVISIONS

1	PLAN CHECK BL1502050086 3/18/15
2	PLAN CHECK BL1502050086 8/26/15
3	PLAN CHECK BL1502050086 9/22/15

A Tenant Improvement For:

FAST AUTO LOANS, INC.

THE CASH YOU NEED... FAST!

4327 E. Cesar Chavez Ave.
Los Angeles, CA 90022

SHEET TITLE

SITE PLAN

DRAWN	JGARCIA
CHECKED	CDKATES
DATE	Sep 25, 2015
SCALE	AS NOTED
JOB NO.	CA-1901

SHEET NUMBER

A1.0